


RESOLUTION R-2021-47

A RESOLUTION AUTHORIZING THE EXECUTION
OF A CERTAIN CONSTRUCTION, USE, AND
INDEMNIFICATION AGREEMENT
(600 Webster Avenue)


BE IT AND IT IS HEREBY RESOLVED by the Mayor and City Council of the City of Wheaton, Illinois, that the Mayor is hereby authorized to sign, and the City Clerk is directed to attest to the Construction, Use, and Indemnification Agreement dated May 6th, 2021, between the City of Wheaton and Ronald Sharkey & Beth Sharkey for 600 Webster Avenue, Wheaton, Illinois, attached hereto as Exhibit 1.

ADOPTED this 7th day of June 2021.

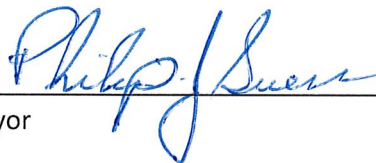

Mayor

ATTEST:



City Clerk

Ayes:

Roll Call Vote:

Councilwoman Robbins
Councilman Weller
Councilman Barbier
Councilwoman Bray-Parker
Councilman Brown
Mayor Sues
Councilwoman Fitch

Nays:

None

Absent:

None

Motion Carried Unanimously

1

2

3

**CONSTRUCTION, USE AND INDEMNIFICATION AGREEMENT
RIGHT-OF-WAY (Webster Ave)
Street Name**

THIS CONSTRUCTION, USE AND INDEMNIFICATION AGREEMENT, made and entered into this 6 day of MAY, 2021, among the City of Wheaton, Illinois, an Illinois corporation, located in DuPage County, State of Illinois ("City"), and Ronald & Beth Sharkey ("Owner").

WITNESSETH

WHEREAS, the City is in possession of a right-of-way within the City limits of the City of Wheaton, Illinois, and legally described herein; and

WHEREAS, Ronald Sharkey & Beth Sharkey (hereinafter "Owner"), the owner of the premises located at 600 Webster Ave, Wheaton, Illinois, which property is legally described herein and is contiguous to a portion of the right-of-way; and

WHEREAS, the Owners would like to use a portion of the City's right-of-way for the purpose of constructing and maintaining a lawn irrigation system; and

WHEREAS, the Owners acknowledges that this Agreement is not an easement and does not vest them with any property rights or claims to any portion of said right-of-way.

NOW, THEREFORE, BE IT AND HEREBY AGREED by the City Council of the City of Wheaton, an Illinois municipal corporation, and the Owner as follows:

1.) The foregoing recitals are incorporated herein as representing the intent of the undersigned and as substantive representations and covenants.

2.) Ronald Sharkey & Beth Sharkey are the owners of property located at 600 Webster Ave, Wheaton, Illinois, legally described on Exhibit A attached hereto and made a part hereof.

3.) The Owners, for a consideration of Ten Dollars (\$10.00) and other good and valuable consideration as stated herein, are hereby authorized to use only that portion of the right-of-way specifically depicted and identified on Exhibit B which is attached hereto and incorporated herein as fully set forth as for construction, maintenance and use of a lawn irrigation system conforming to all applicable ordinances of the City and this Agreement. The ordinances are material terms and conditions of this Agreement.

4.) The City retains the right to enter said right-of-way for any purpose to perform any work including but not limited to constructing and maintaining the City utility systems (watermain, storm and sanitary sewers) and other infrastructure. If the City performs any work within said right-of-way which causes damage to the lawn irrigation system, the Owners shall be responsible to repair the lawn irrigation system at their sole cost and expense. The Owner hereby acknowledges and agrees that the City, its employees, and agents shall have no liability to the owner for any damage, removal or other casualty to the lawn irrigation system caused by the City, its employees or agent regardless of the cause.

5.) The City may terminate and cancel this Agreement together with all rights and privileges granted hereunder, by notifying the Owners in writing at least fourteen (14) days prior to termination.

6.) Upon termination of this Agreement, the City may destroy, demolish, or remove any improvements placed upon the right-of-way by the Owners without liability.

7.) To the greatest extent permitted under Illinois law, Owners shall defend, indemnify and hold the City harmless from any and all claims, actions, causes of action, costs, judgments, injuries, property damage, expenses (including reasonable attorney's and expert's fees) which arise or may be caused by the negligence of the Owners, or Owners' agents, as a result of the design, construction, maintenance, use or abandonment of the lawn irrigation system described herein.

8.) This Agreement is not an easement. Should a court of competent jurisdiction construe it as an easement it shall be a temporary easement which shall expire 14 days after such construction.

9.) The provisions set forth in this Agreement and exhibit represent the entire Agreement between the parties and shall precede all prior agreements, contracts, understandings, promises and representations, oral or written, as it is the intent of the parties to provide for a complete integration within the terms of this Agreement. This Agreement may be modified only by a further written Agreement between the parties, and no modification shall be effective unless properly approved and signed by each party.

10.) This Agreement shall be recorded in the Office of the Record of Deeds, DuPage County, Illinois, at the expense of the Owners.

11.) The Owners obligations under this Agreement shall be joint and several.

12.) This Agreement shall be binding on the Owners, their successors, heirs and assigns.


IN WITNESS WHEREOF, the Corporate authorities and the Owners have hereunto set their hands and seals, and have caused this instrument to be executed by their duly authorized officials and the Corporate seal attached here all on the date and year first above written.

x Ronald F. Alastey
Owner

x Beth A. Shaker
Owner

Subscribed and sworn to before me this 16th day of May, 2021

Regina Gutierrez Notary Public
(Notary Seal)

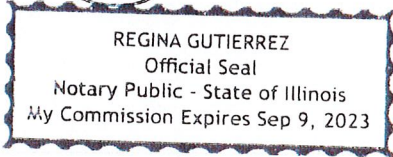

Philip J. Swann
Mayor, City of Wheaton

Attested by:
Marion Bennett Hagen
City Clerk

EXHIBIT A

Legal Description:

LOT 2 IN 819 UNIVERSITY PLACE SUBDIVISION BEING A
RESUBDIVISION OF LOT 2 (EXCEPT THE NORTH 23 FEET
OF THE WEST 15 FEET THEREOF) IN DAESCHNER'S ASSESSMENT
PLAT OF PARTS OF THE NORTH HALF OF THE NORTHEAST
QUARTER OF SECTION 16, TOWNSHIP 39 NORTH, RANGE
10 EAST OF THE THIRD PRINCIPAL MERIDIAN
ACCORDING TO THE PLAT THEREOF RECORDED JUNE 24
2008 AS DOCUMENT NUMBER R08-101045 IN THE
CITY OF WHEATON DUPAGE COUNTY, ILLINOIS

600 Webster Ave. Wheaton, IL 6018__
Street Name

P.I.N. 05-16-213-031

AS-BUILT TOPOGRAPHIC SURVEY

LOT 2 IN BIG UNIVERSITY PLACE SUBDIVISION, BEING A RECONSTRUCTION OF LOT 2 (EXCEPT THE NORTH 20 FEET THEREOF) AS SHOWN ON THE PLAT OF THE SAID SUBDIVISION AND BEING A RECONSTRUCTION OF LOT 2 (EXCEPT THE NORTH 20 FEET THEREOF) AS SHOWN ON THE PLAT OF THE SAID SUBDIVISION AND BEING A RECONSTRUCTION OF LOT 2 (EXCEPT THE NORTH 20 FEET THEREOF) AS SHOWN ON THE PLAT OF THE SAID SUBDIVISION.

DATE OF SURVEY: 05-16-21
 SURVEYOR: [Signature]
 TITLE: [Signature]

SURVEY LEGEND


- CONCRETE FOUNDATION
- CONCRETE WALL
- CONCRETE CURB
- CONCRETE DRIVE
- CONCRETE SIDEWALK
- CONCRETE WALK
- CONCRETE DRIVE
- CONCRETE SIDEWALK
- CONCRETE WALK
- CONCRETE DRIVE
- CONCRETE SIDEWALK
- CONCRETE WALK

TREE SPECIES	D.B.H.	CLASSIFICATION
1	14"	SPRINKLER
2	14"	SPRINKLER
3	30"	SPRINKLER
4	30"	SPRINKLER

SPRINKLER KEY

- SPRINKLER
- SPRINKLER
- SPRINKLER
- 1" RPZ VALVE
- TRIPER

LARGEST ZONE IS 12 GPM

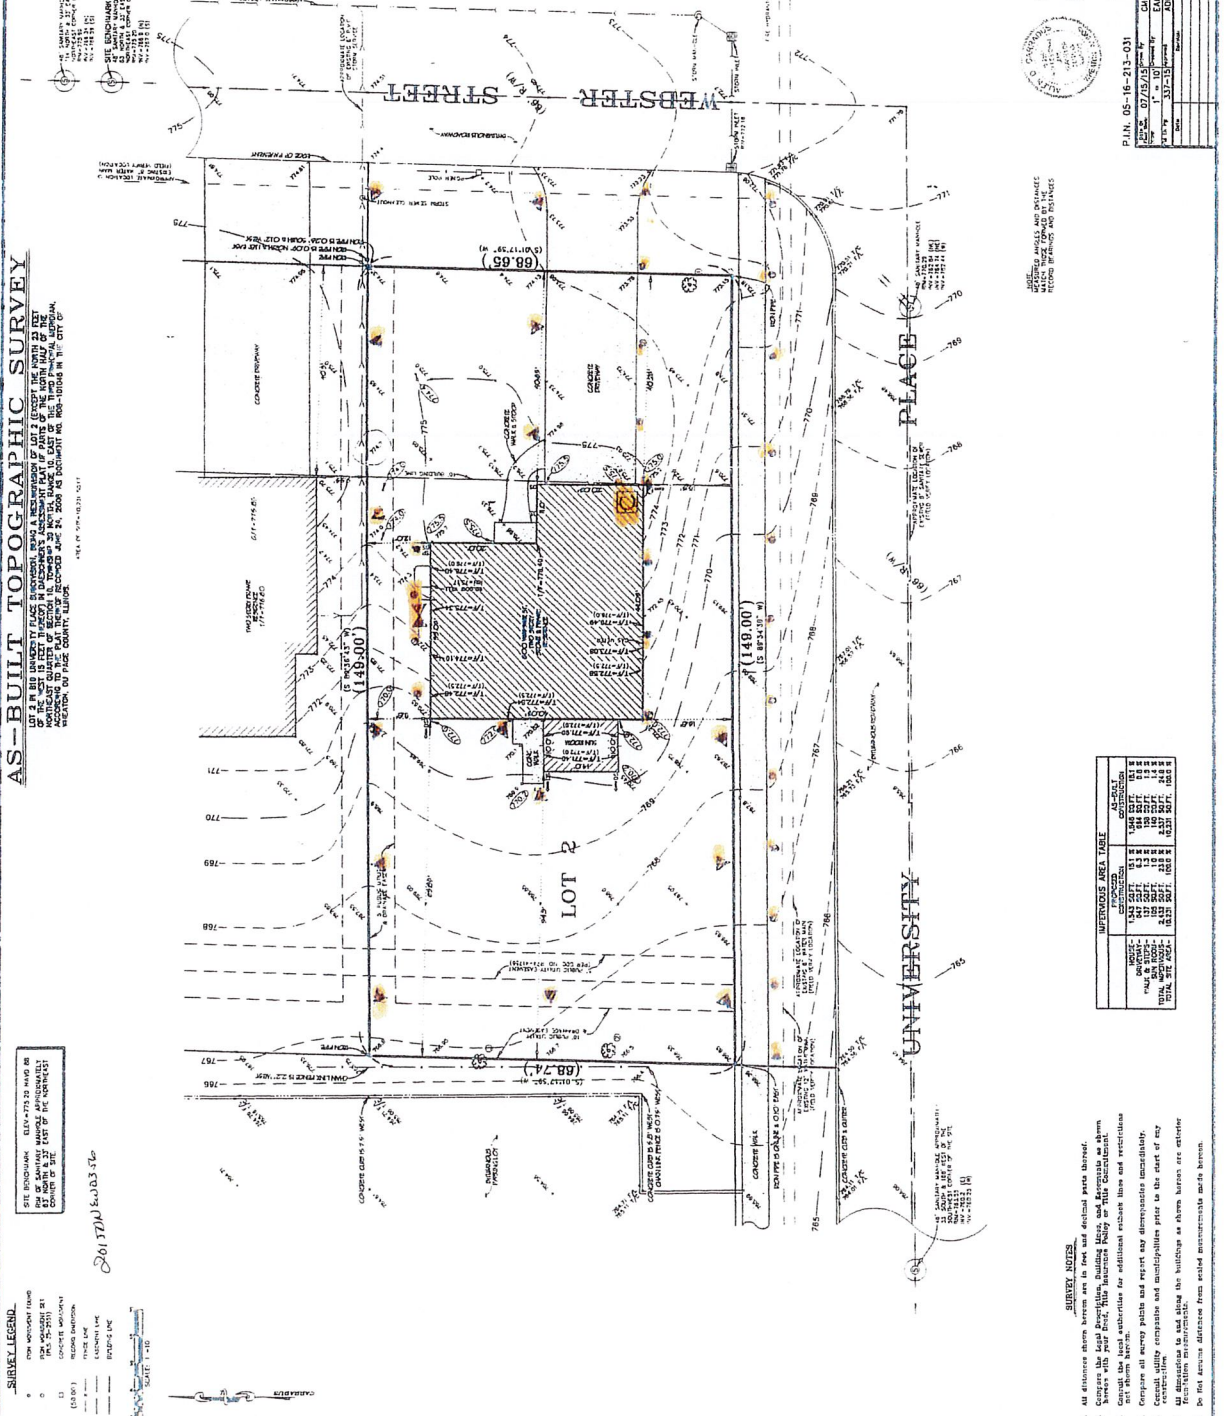

RECEIVED
 JUN 21 2021
 ENGINEER'S COVER SHEET

STATE OF ALABAMA
 COUNTY OF BARBOUR

DATE OF SURVEY: 05-16-21
 SURVEYOR: [Signature]
 TITLE: [Signature]

PREPARED BY: [Signature]
 CHECKED BY: [Signature]
 DRAWN BY: [Signature]

DATE OF SURVEY: 05-16-21
 SURVEYOR: [Signature]
 TITLE: [Signature]

DATE OF SURVEY: 05-16-21
 SURVEYOR: [Signature]
 TITLE: [Signature]

AREA	AREA	PERCENTAGE	ADJUSTED AREA
CONCRETE DRIVE	1.42	100.00	1.42
CONCRETE SIDEWALK	1.42	100.00	1.42
CONCRETE WALK	1.42	100.00	1.42
CONCRETE DRIVE	1.42	100.00	1.42
CONCRETE SIDEWALK	1.42	100.00	1.42
CONCRETE WALK	1.42	100.00	1.42
TOTAL	5.54		5.54

DATE OF SURVEY: 05-16-21
 SURVEYOR: [Signature]
 TITLE: [Signature]

(

(

(